



RICE COUNTY SEPTIC SYSTEM INSPECTION FORM


PID# 06.04.4.25-002 Owner: Will Jones Inspection Date: 11/13/09

Address: 4325 Clearwater Tr Bedrooms 4 Standard Performance Other Community System
 New Replacement

SETBACKS:
Buildings to tank..... 67 ft
Buildings to dispersal system..... 91 ft
Well >50ft >100ft..... 160 ft
Well installation pending
Waterbody: Wetland _____ Lk. 80 ft
Property Boundaries (per submitted info.) >10 ft
Trench: Rock Graveless Chamber
Depth _____ " Width _____ ft Media below 12" (Reduction)
Pressurized: Mound At-Grade Bed Trench

SEPTIC TANK:
 New... Existing compartments 1 2 filter 1500 gallon
maintenance access... inlet outlet center 4.25.3 riser
Septic Tank #2 Insulated top sides cover
 New... Existing compartments 1 2 filter _____ gallon
maintenance access... inlet outlet center _____ riser
Existing tank abandoned Yes No Pump Certificate for Existing Tanks
PUMP TANK: 1000 gallon PUMP: 29 gpm 14 ft. head
ALARM: audio visual location: house tanks or _____
maintenance access... inlet outlet center 3 riser

Rockbed 10 x 150 ' Flushing Valves cycle counter water meter Pumpline: diameter 1.5" 2" length 30 ft
#Laterals 3 space between 30 40 diameter 1.5 " perforations 1/4 " @ 4 ft. (squirt ht _____)
Mound 12 " sand 12 % Dike: up 9 ' side 9 ' down 33 ' Backfill 12-18 " actual expected
System Size: 68 sq.ft. _____ lineal ft. Vegetation cover to be established by: Owner Septic Installer

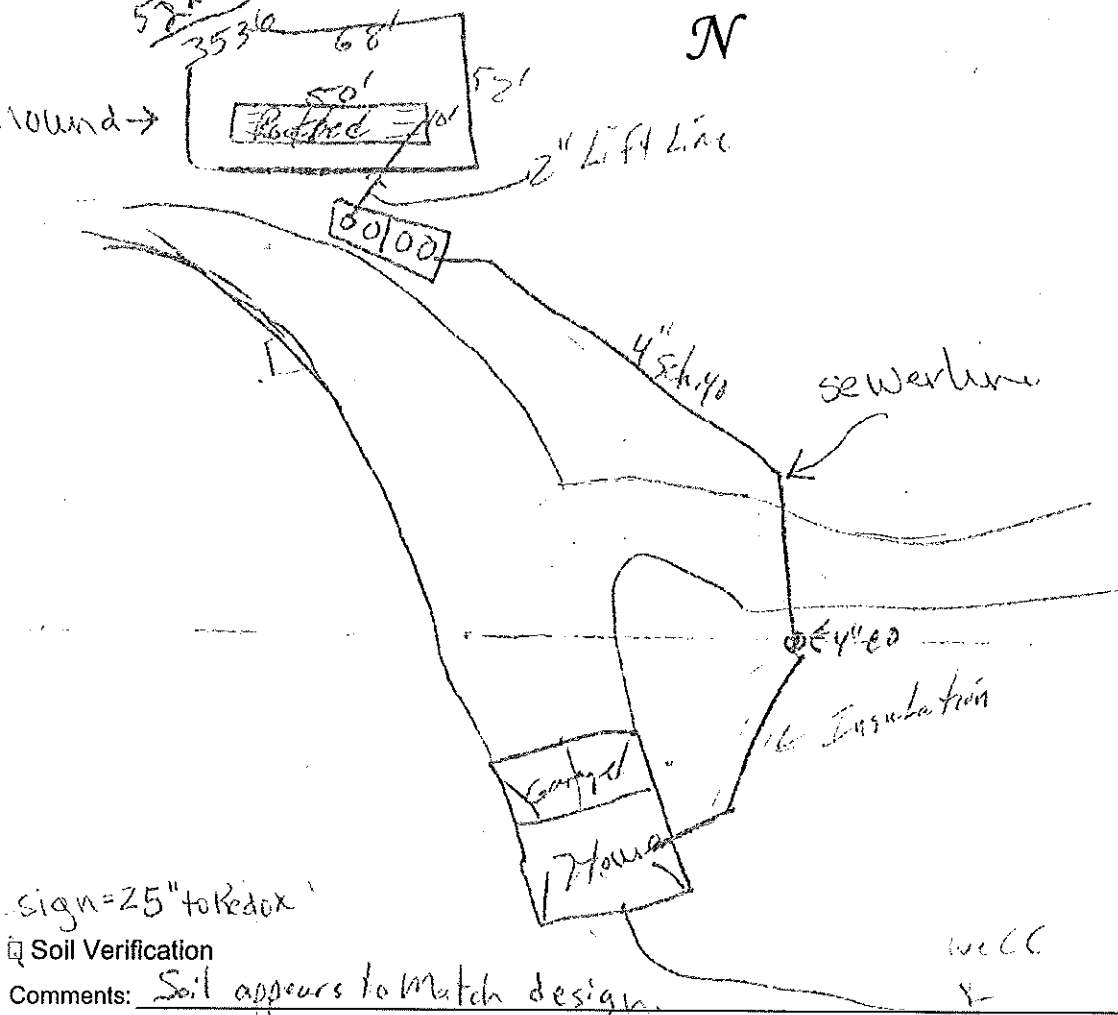

Soil Verification
Comments: Soil appears to match design.

I certify with my signature that based upon the certification of the Designer or Installer and the limited county inspection, the septic system appears to be 'In Compliance' with the Rice County Sewage and Wastewater Treatment Ordinance

I hereby certify, as the Installer, that the septic system was installed in accordance with the Rice County Sewage and Wastewater Treatment Ordinance. I agree to comply with the requirements to finish or correct the system and to indemnify and save Rice County from all loss, damages, costs and charges that may be incurred by the county because of my failure to conform to and comply with the provisions of this ordinance. I also verify that all plumbing fixtures discharge into this septic system.

Wade S. M
INSPECTOR

Will Jones
INSTALLER Name SIGNATURE